
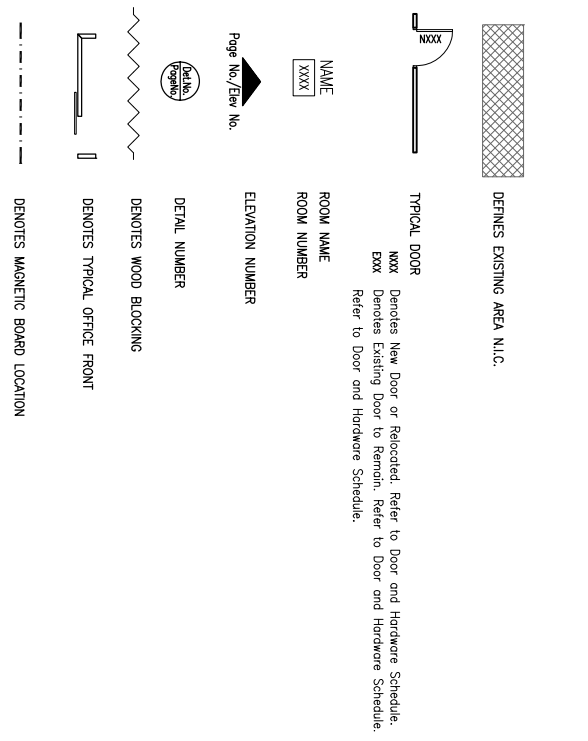


LEGEND: PARTITION AND CONSTRUCTION

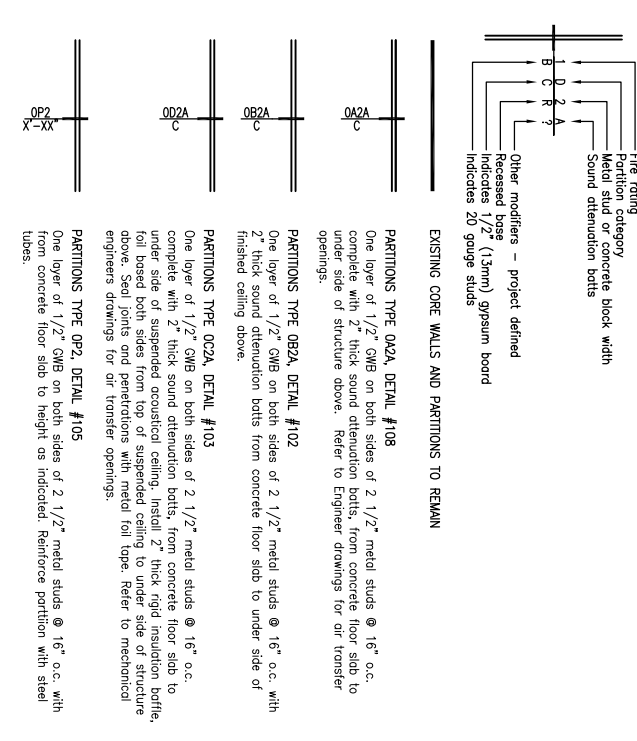


NOTE: PARTITION AND CONSTRUCTION


1. READ IN CONJUNCTION WITH THE PROJECT REQUIREMENTS.
2. LAYOUT, ON THE FLOOR, ALL PARTITION LOCATIONS FOR CONSULTANT'S REVIEW. ADJUST LOCATIONS AS REQUIRED BASED ON REVIEW.
3. UNLESS DIMENSIONS OTHERWISE PARTITIONS SHALL BE LOCATED AS FOLLOWS:
 - a) CENTERED ON T-BARS, OR
 - b) CENTERED ON PERIMETER GLAZING WALLS, OR
 - c) 4" FROM 90 DEGREES TO THE CEILING GRID
4. PARTITION DIMENSIONS ARE FROM THE CENTERLINE OF PARTITION UNLESS NOTED AS A "TOLERANCE". DIMENSIONS FROM FACE OF PARTITION, CLEAR DIMENSIONS MUST BE HEAD TO A TOLERANCE OF 1/8" (3mm).
5. EXPOSED FACE OF T-BAR COMPONENTS
6. DO NOT PENETRATE FACE OF PERIMETER WALLS OR WALLS AT PARTITION INTERSECTION. USE ADHESIVE FRAID CLOSED CELL FRAID GASKETS AT WALLION INTERSECTIONS.
7. WHERE PARTITIONS ARE CONSTRUCTED OVER PERIMETER INDUCTION UNITS ENSURE ADEQUATE SPACE IS PROVIDED TO ALLOW REMOVAL OF THE INDUCTION UNIT ACCESS PANELS AND GRILLS.
8. PROVIDE ADEQUATE FIRE TREATED OR NON-COMBUSTIBLE BLOCKING IN PARTITIONS TO SUPPORT SHELVING, HANG BARS, MILLWORK, GRAB BARS, ACCESSORIES AND OTHER ITEMS THAT ARE PART OF THIS CONSTRUCTION.
9. PROVIDE ADEQUATE FIRE TREATED OR NON-COMBUSTIBLE BLOCKING INDICATED ON DRAWINGS. 4" BEYOND WALL HANG UNIT.
10. SOUND ATTENUATION BARRIERS SHALL BE INSTALLED CONTIGUOUSLY BEHIND ALL POWER, VOICE AND DATA OUTLETS, AND OTHER DEVICES NECESSARY WITH PARTITIONS. BLOCKING TO EXTEND TO MECHANICAL DRAWINGS.
11. PROVIDE ADEQUATE BARRIERS IN CONNECTIONS WHERE PARTITIONS MEET CONNECTIONS. REFER ALSO TO MECHANICAL DRAWINGS.
12. COMPONENT ALL BASE TYPES WITH PERIMETER PARTITION CONSTRUCTION. REFER TO FLOOR FINISH PLANS.
13. ALL PARTITIONS SCHEDULED TO RECEIVE RESILIENT BASE ARE TO BE COMPLETELY FINISHED SMOOTH TO THE SLAB.
14. ALL DOOR FRAMES TO BE 4" FROM CORNER OF ROOM UNLESS NOTED OTHERWISE.
15. COLUMNS, EXTERIOR WALLS, BRIDGING CORE WALLS ETC. TO BE FINISHED OUT AS REQUIRED FOR FINISHING AND CONSTRUCTION DETAILS.
16. REPORT ON THE PARTITION AND CONSTRUCTION DETAILS. LOCATIONS OF BLOCKING TO SUPPORT ALL WALL AND CEILING FINISHING. FINISHING DETAILS TO BE PROVIDED TO SUPPORT ALL WALL AND CEILING FINISHING.
17. FLOORS TO BE MADE LEVEL TO A TOLERANCE OF 1/4" PER 10 FEET (from PER 3.0) PRIOR TO DOORS OPENING 180 DEGREES AND OTHER AREAS WHERE A LEVEL FLOOR IS CRITICAL.

Office Requisition
Mediacom Group Services
 1 Dundas Street West

Prepared for
Mediacom
 Toronto, ON M5G 1Z3
 Contract No: 06-32070-00

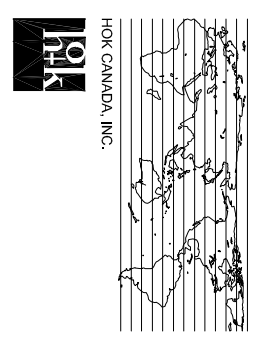

225 King Street West, Suite 3000
 Toronto, Ontario M5X 1C4
 Phone: (416) 593-8800
 Fax: (416) 593-8802
 Website: www.hok.com
 Introduction with:
Hill Risk Consulting Engineers Inc.
 Toronto, Ontario M5S 1E5
 T: 416-944-4210
 F: 416-944-2278

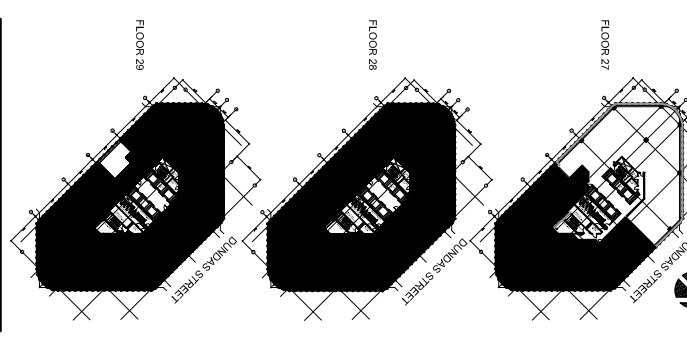

No.	Issue Description	Date
1	Issued for PERMIT	11/24/06
2	Issued for Tender	11/24/06
3	Issued for Construction	12/19/06
4	Record Set	02/21/07

Drawn by: **AB/TM** Reviewed by: **DS**
 Project No: **06-32070-00**
 Sheet Title: **A1-27 PARTITION PLAN.dwg**

PARTITION PLAN
27TH FLOOR
A1-27