




Cadillac
Fairview

Version	Created: 03/09/2020
FP2A	Measured: 11/18/2010

Tower 5
222 Bay Street
Toronto, Ontario, Canada
Floor 16

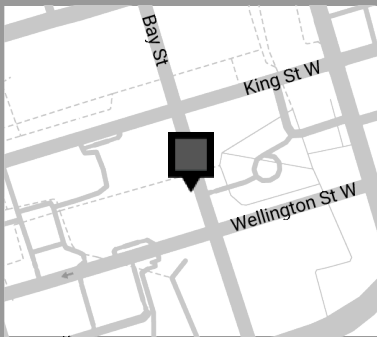

This work product has been prepared by Extreme Measures Inc. pursuant to a contract with the Client for the sole benefit of and use by the Client. No third party may rely on this work product without the receipt of a reliance letter from Extreme Measures Inc.

