

Client: The Cadillac Fairview Corporation Limited




Cadillac
Fairview

Version	Created: 20/02/2025
FP1A	Measured: 04/02/2025

TD West Tower (Tower 3)
100 Wellington Street West
Toronto, Ontario, Canada

Floor 18

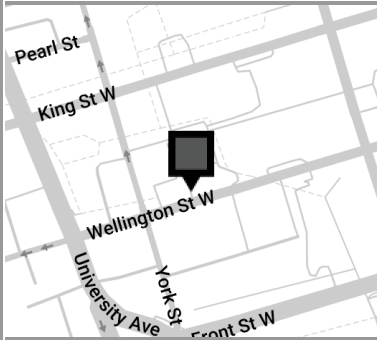

This work product has been prepared by Extreme Measures Inc. pursuant to a contract with the Client for the sole benefit of and use by the Client. No third party may rely on this work product without the receipt of a reliance letter from Extreme Measures Inc.