


Office Requisition  
**Mediacom Group Services**  
 1 Dundas Street West


Prepared for  
**Mediacom**

Toronto, ON M5G 1Z3  
 Contact No: 06-32070-00

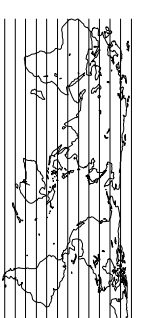

HOK CANADA, INC.

225 King Street West, Suite 3000  
 Toronto, Ontario M5X 1C3  
 Tel: 416 593 8800  
 Fax: 416 593 8802  
 Website: www.hok.com  
 All information is subject to change without notice.  
 Information only  
**Hidi Rea Consulting Engineers Inc.**  
 200 Dundas Street West, Suite 1100  
 Toronto, Ontario M5G 1R5  
 Tel: 416-593-4210  
 Fax: 416-593-4278

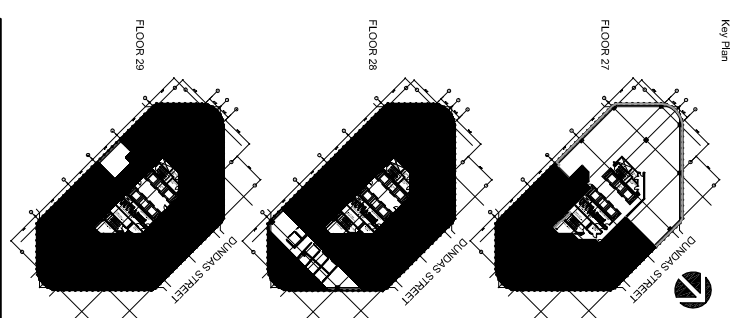

No.	Issue Description	Date
1	Issued for PERMIT	11/24/06
2	Issued for TENDER	11/24/06
3	Issued for Construction	12/19/06
4	Record Set	02/21/07

Drawn by: **AB/TM** Reviewed by: **DS**  
 Project No: **06-32070-00**  
 A1-28 PARTITION PLAN.dwg  
 Sheet Title:

**PARTITION PLAN**  
**28TH FLOOR**

**A1-28**