




Cadillac  
Fairview

Version	Created: 07/24/2024
<b>FP6A</b>	Measured: 07/23/2024

TD North Tower (Tower 2)  
77 King Street West  
Toronto, Ontario, Canada

Floor 42

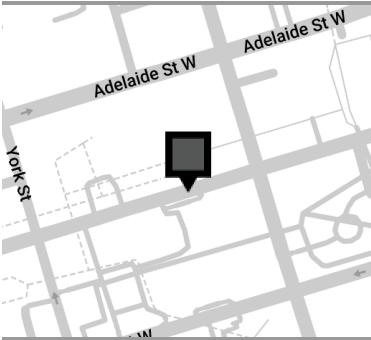

This work product has been prepared by Extreme Measures Inc. pursuant to a contract with the Client for the sole benefit of and use by the Client. No third party may rely on this work product without the receipt of a reliance letter from Extreme Measures Inc.

This work product or portions thereof relies upon information provided by the Client and/or from third parties introduced by the Client that has not been independently verified by Extreme Measures Inc. Extreme Measures Inc. is not liable for any errors, omissions or inaccuracies that may result from such information.

